

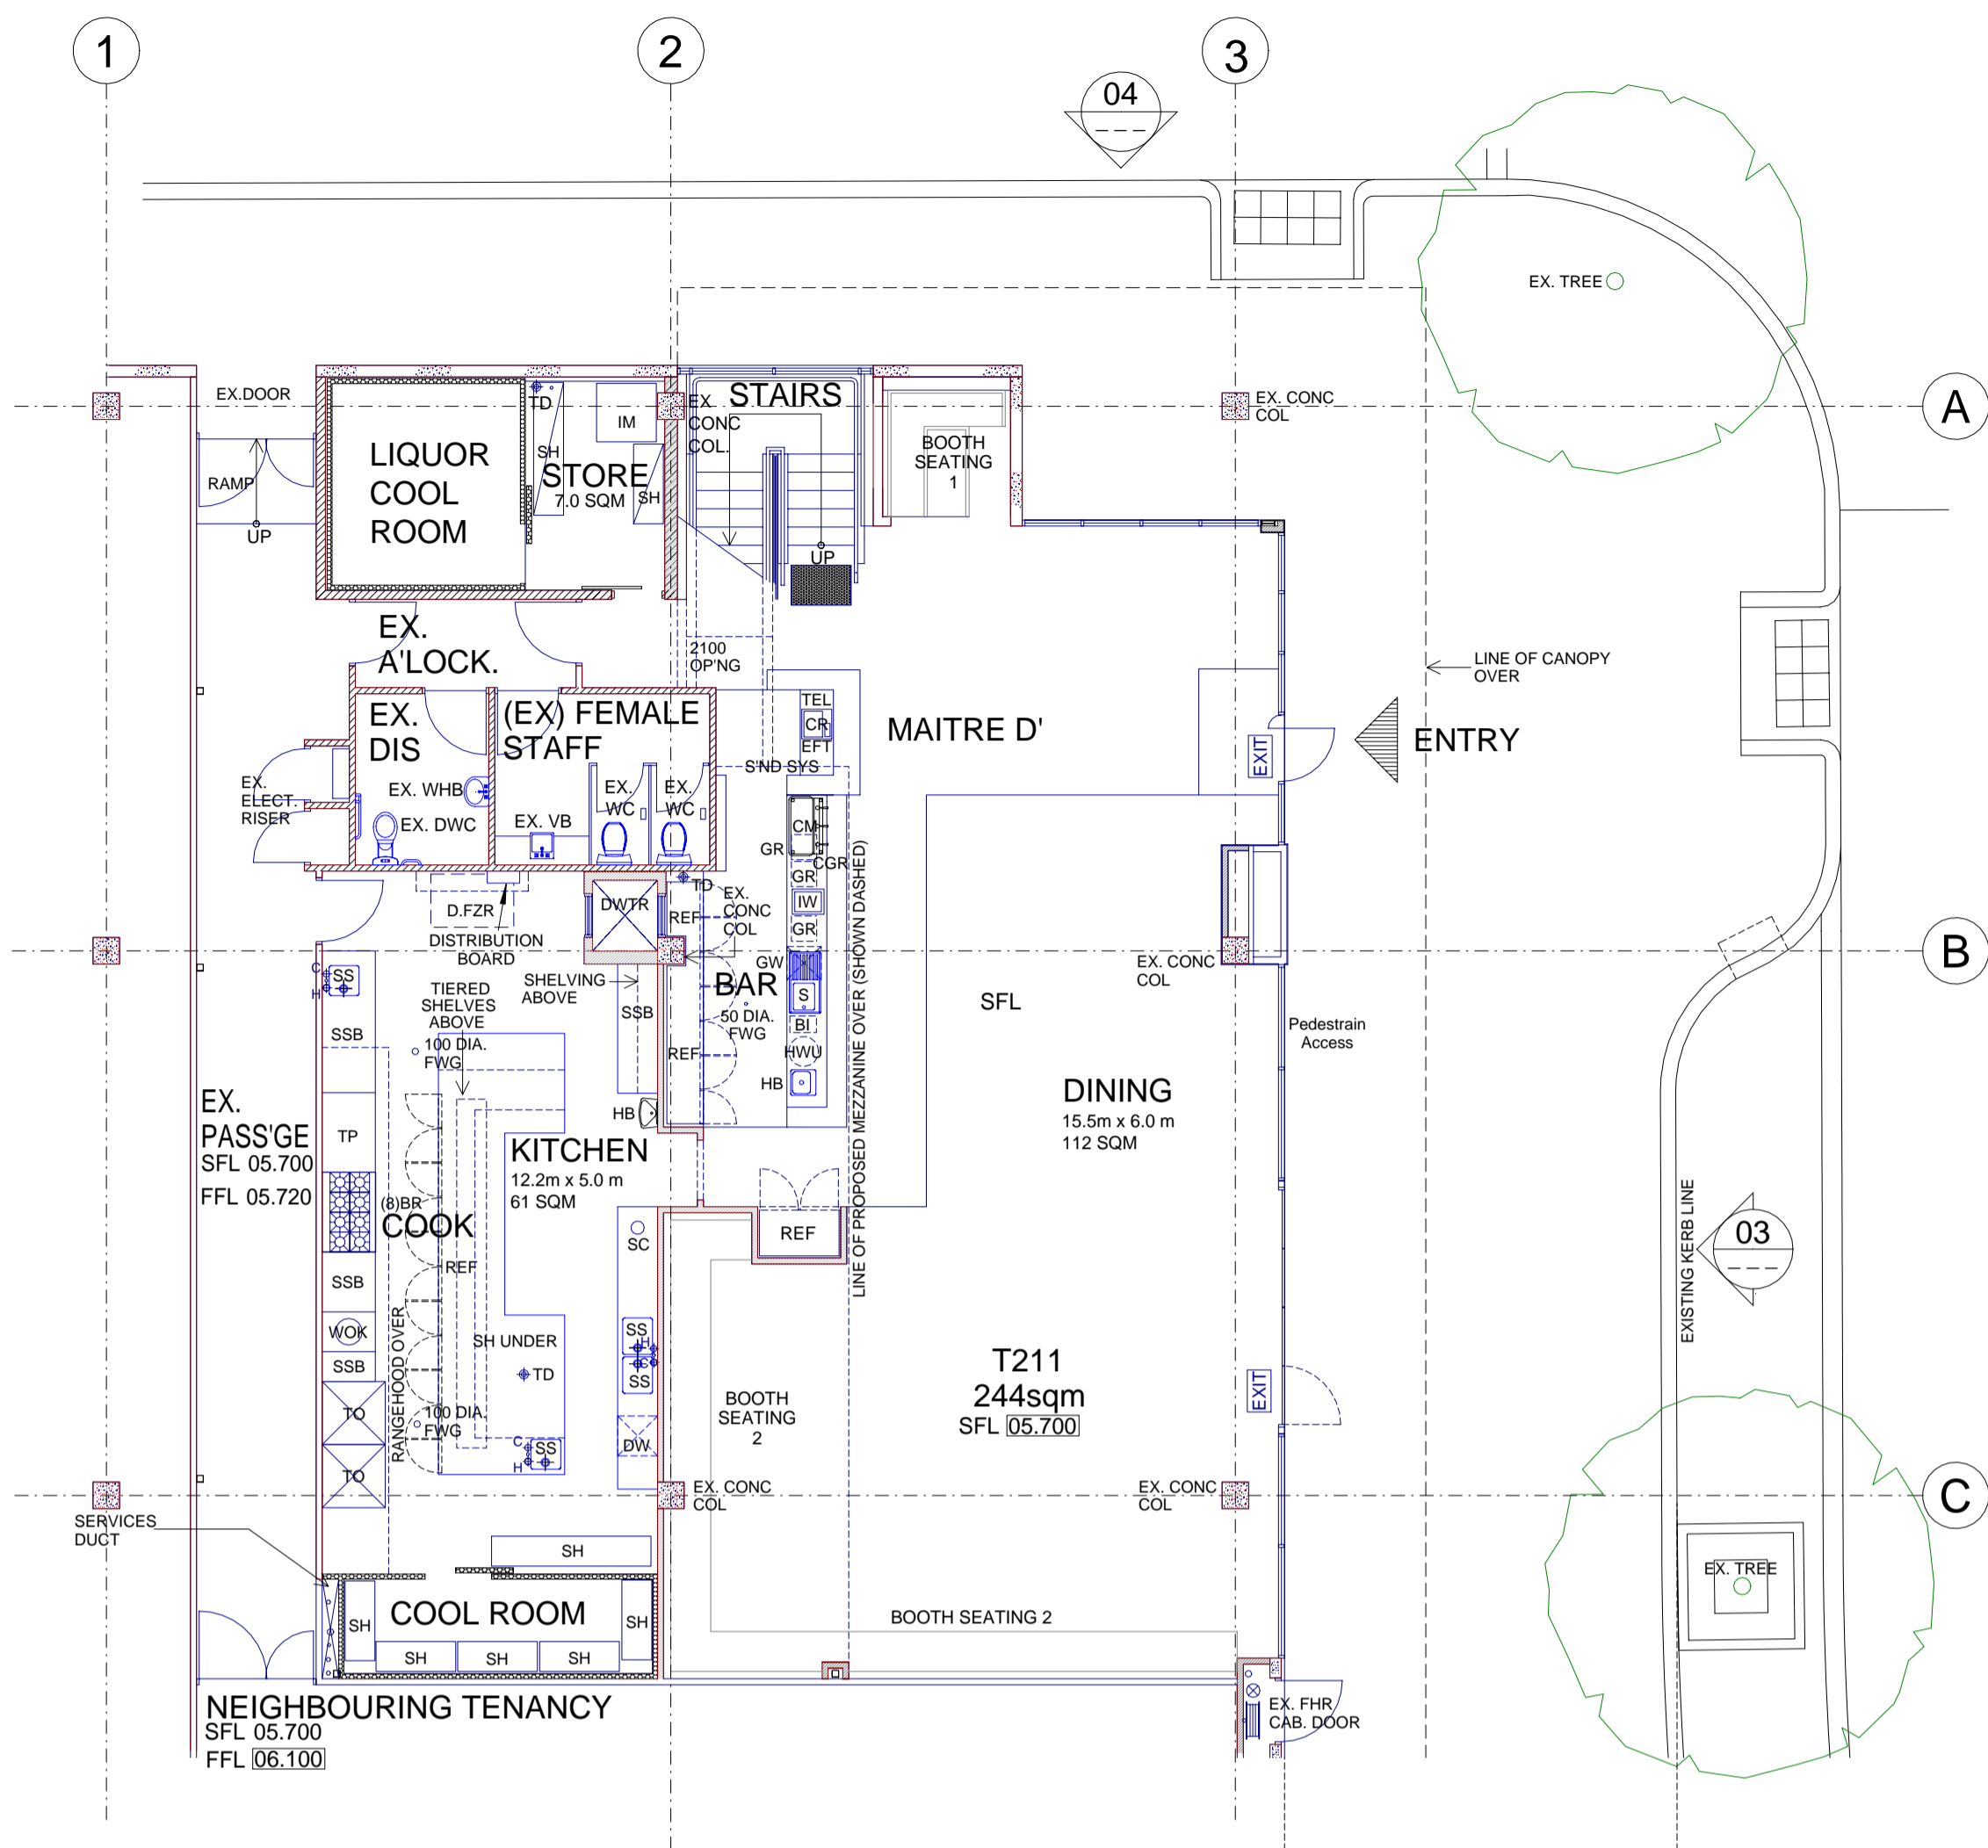




ABBREVIATIONS	
GENERAL	
COL	COLUMN
CS	CLEANERS SINK
HB	HAND BASIN
UR	URINAL
VB	VANITY BASIN
WC	WATER CLOSET
FINISHES	
AG	AGGREGATE
CA	CARPET
CT	CERAMIC TILE
CONC	CONCRETE (MONOLITHIC)
EX	EXISTING
F	FLOOR
FJFB	FLUSH JOINTED PLASTERBOARD
MRFP	MOISTURE RESISTANT FLUSH PLASTERBOARD
MW	MATWELL
PV	PAVING
TGSI	TACTILE GROUND SURFACE INDICATOR
TI	TIMBER
V	VINYL
BAR, KITCHEN FIXTURES & EQUIP.	
BI	BIN
(B)BR	(B)URNER
CM	CAPUCCINO MACHINE
CPD	CUPBOARD
CGR	COFFEE GRINDER
CR	CASH REGISTER
CT	COOKTOP
DFZR	DEEP FREEZER
DW	DISHWASHER
EFT	EFTPOS
FRZ	FREEZER
FWG	FLOOR WASTE GULLY (100/50 DIA FWG REFERS TO 100mm/50mm DIAMETER RESPECTIVELY)
G	GLASS RACK
GW	GLASS WASHER
HB	HAND BASIN
HWU	HOT WATER UNIT
IW	ICE WELL
REF	REFRIGERATOR
S	SINK BOWL
S/SYS	SOUND SYSTEM
SH	SHELF
SS	STAINLESS STEEL INSET SINK
SSB	STAINLESS STEEL BENCH
TO	TANDOORI OVEN
TEL	TELEPHONE
TP	TILTING PAN
TD	TUNDISH
WOK	WOK COOKER

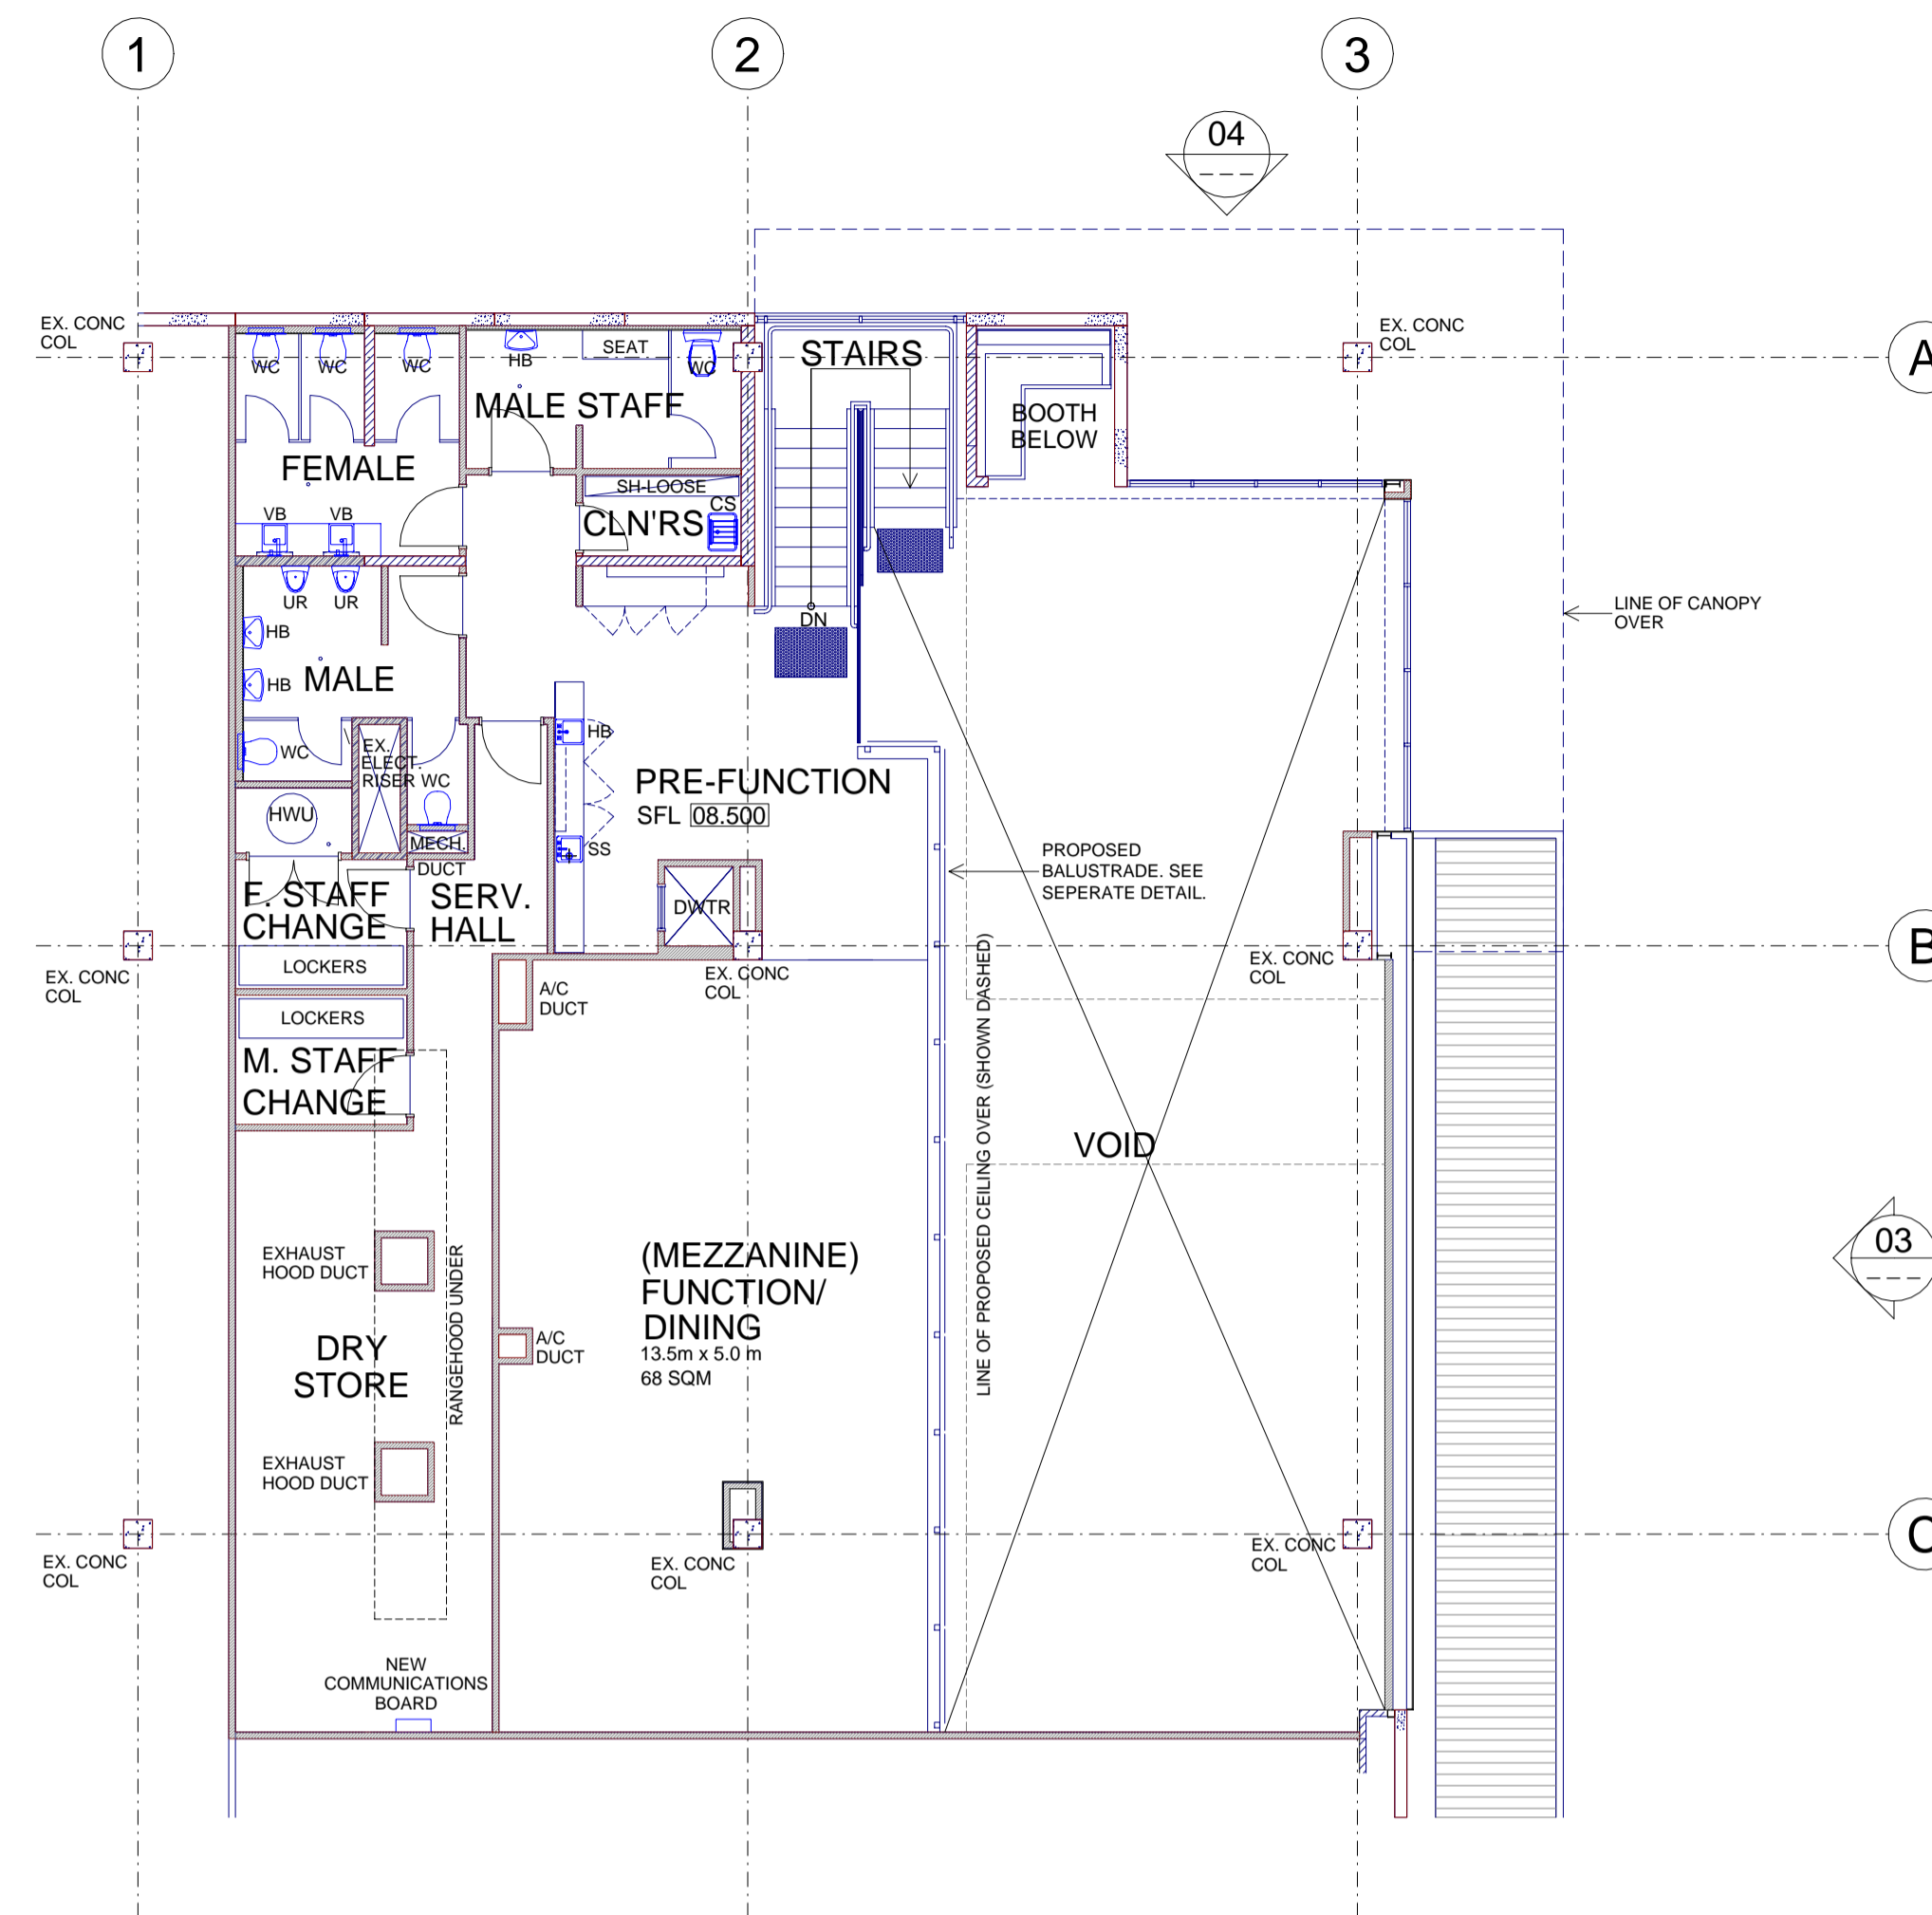


01 GROUND FLOOR PLAN  
SCALE 1 : 100

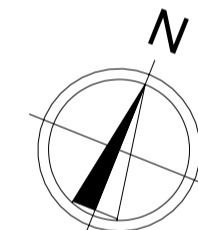


02 FIRST FLOOR PLAN  
SCALE 1 : 100

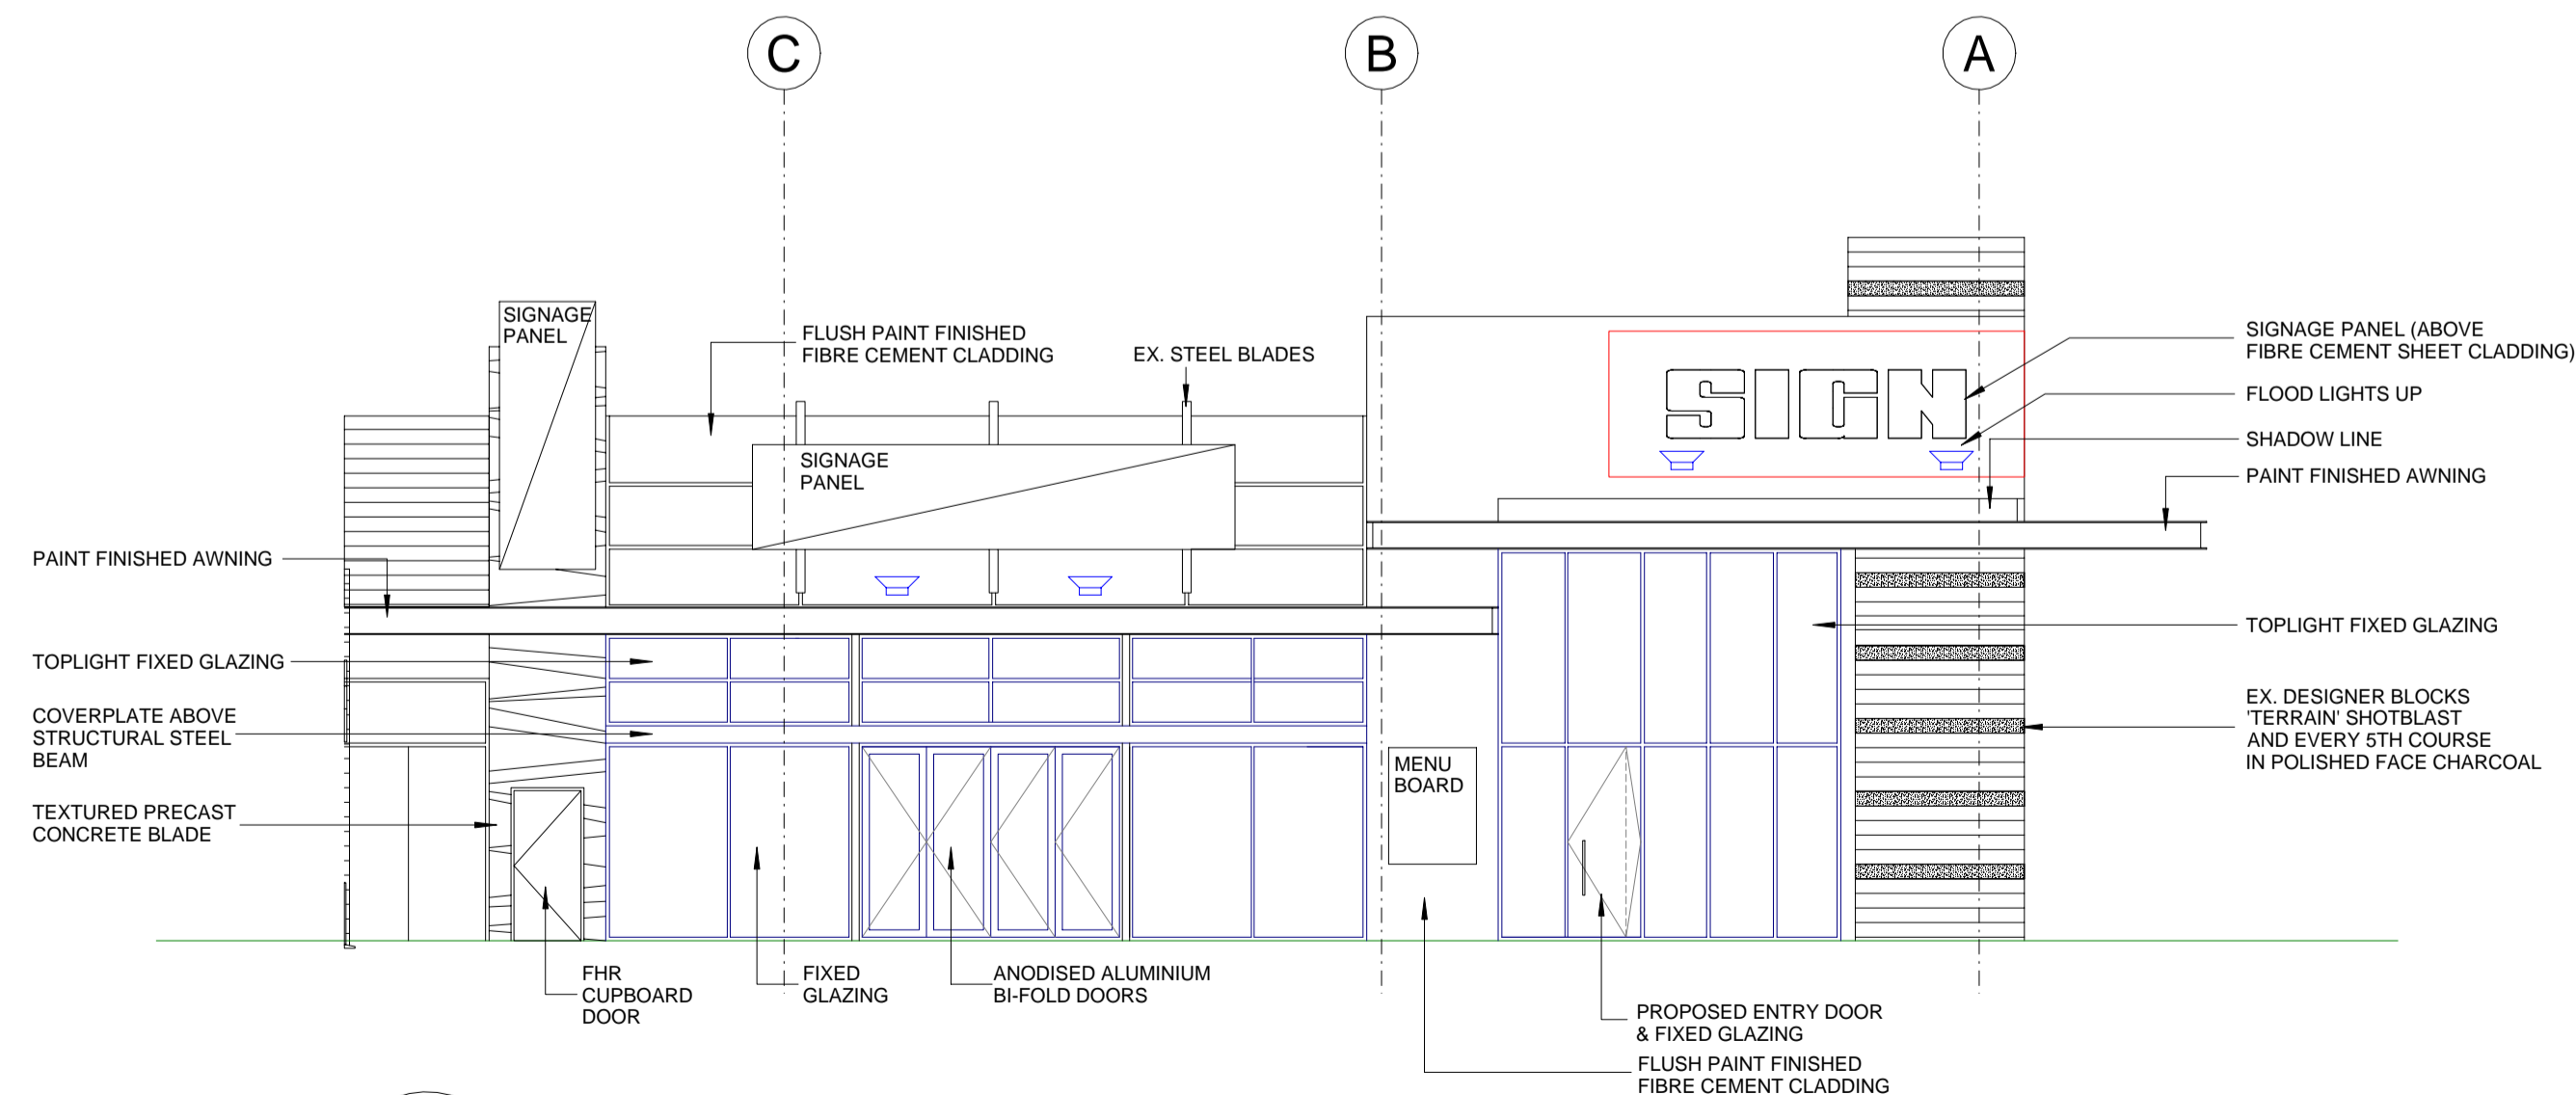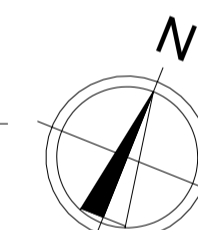

03 EAST ELEVATION  
SCALE 1 : 100

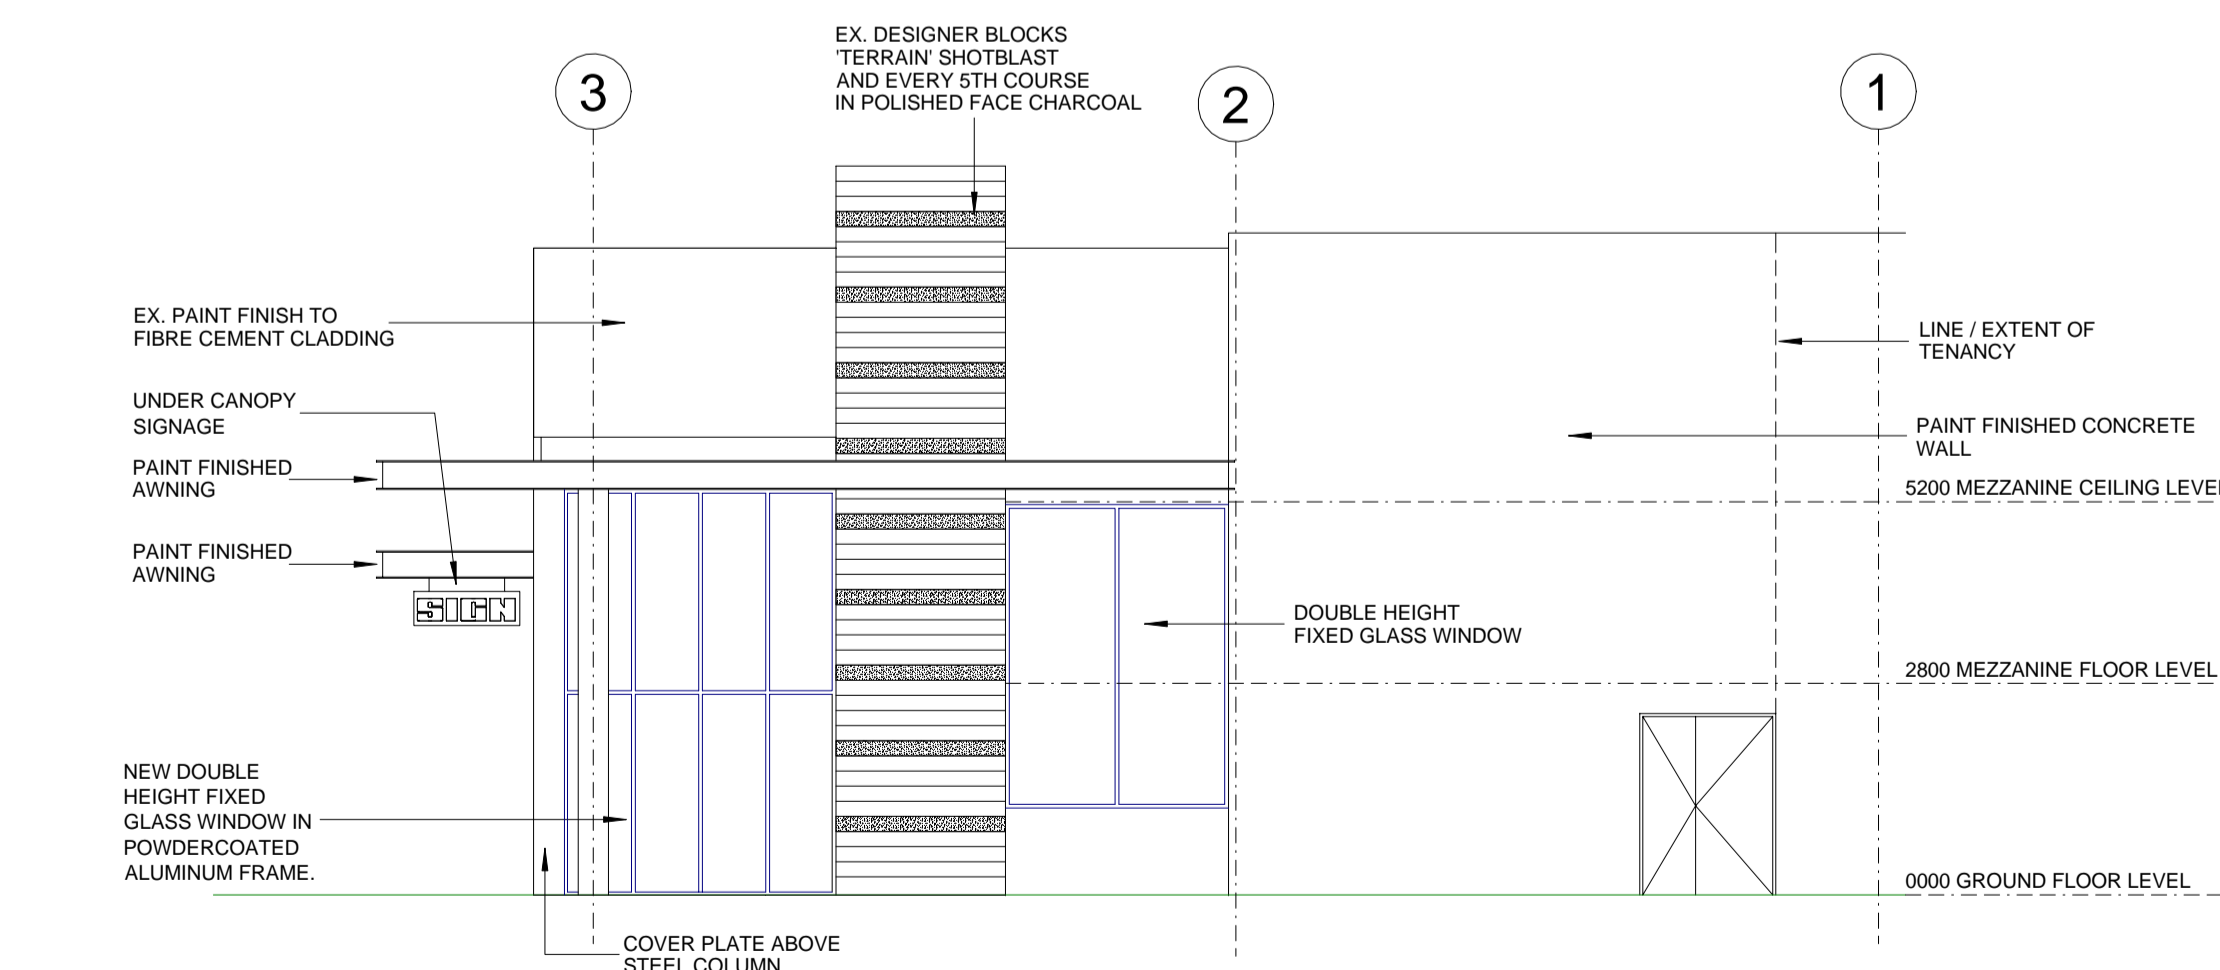

04 NORTH ELEVATION  
SCALE 1 : 100

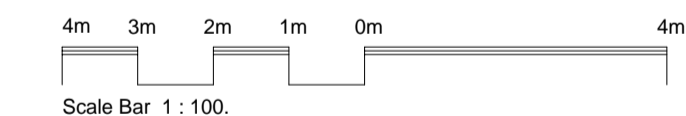

No	DESCRIPTION	DATE	BY	CHKD
1	AS CONSTRUCTED	05.10.09	AM	-
0	BUILDING LICENCE APPLICATION	30.06.09	CJW	-
No	AMENDMENT		DWN	DATE/CHKD

LIQUOR LICENCE

PROJECT: **CHUTNEY MARYS RESTURANT FITOUT**  
TENANCY T211  
ROCKINGHAM CITY SHOPPING CENTRE  
WA 6168

**OLDFIELD KNOTT ARCHITECTS PTY. LTD.**  
567 HAY STREET, DAGLISH 6008  
P.O. BOX 849, SUBIACO, W.A. 6904  
TEL: (08) 9381 6788 FAX: (08) 9381 4619  
EMAIL: oka@okarch.com.au

GROUND / FIRST FLOOR PLAN PROPOSED

SCALE	CHECKED	JOB No.	DRAWING No.	REV.
1:100	-			
DATE	DRAWN	<b>08254</b>	<b>L.03</b>	<b>1</b>
JUL 2009	CJW			